




As Built Drawing
BHU Broze

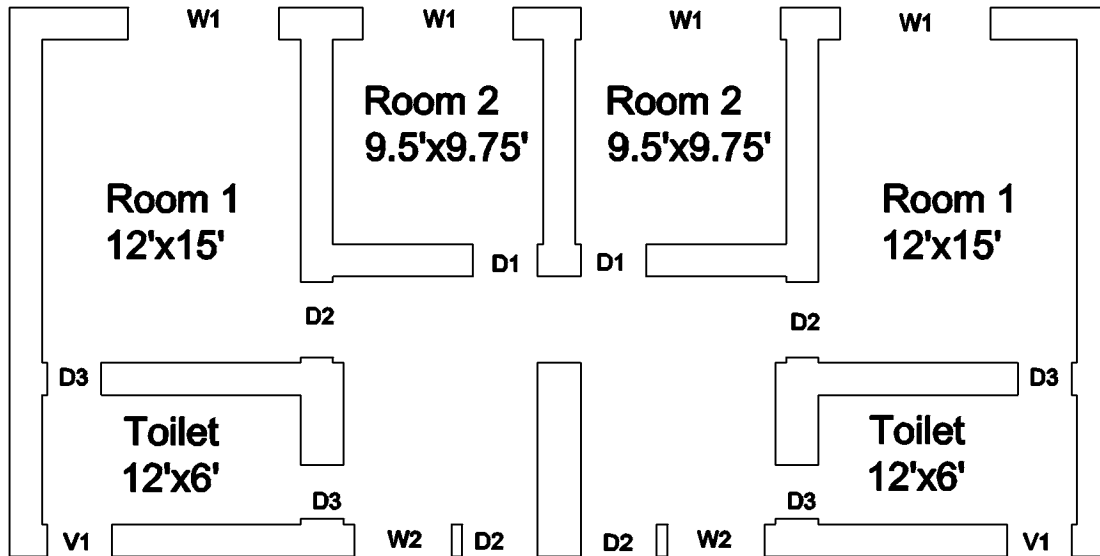