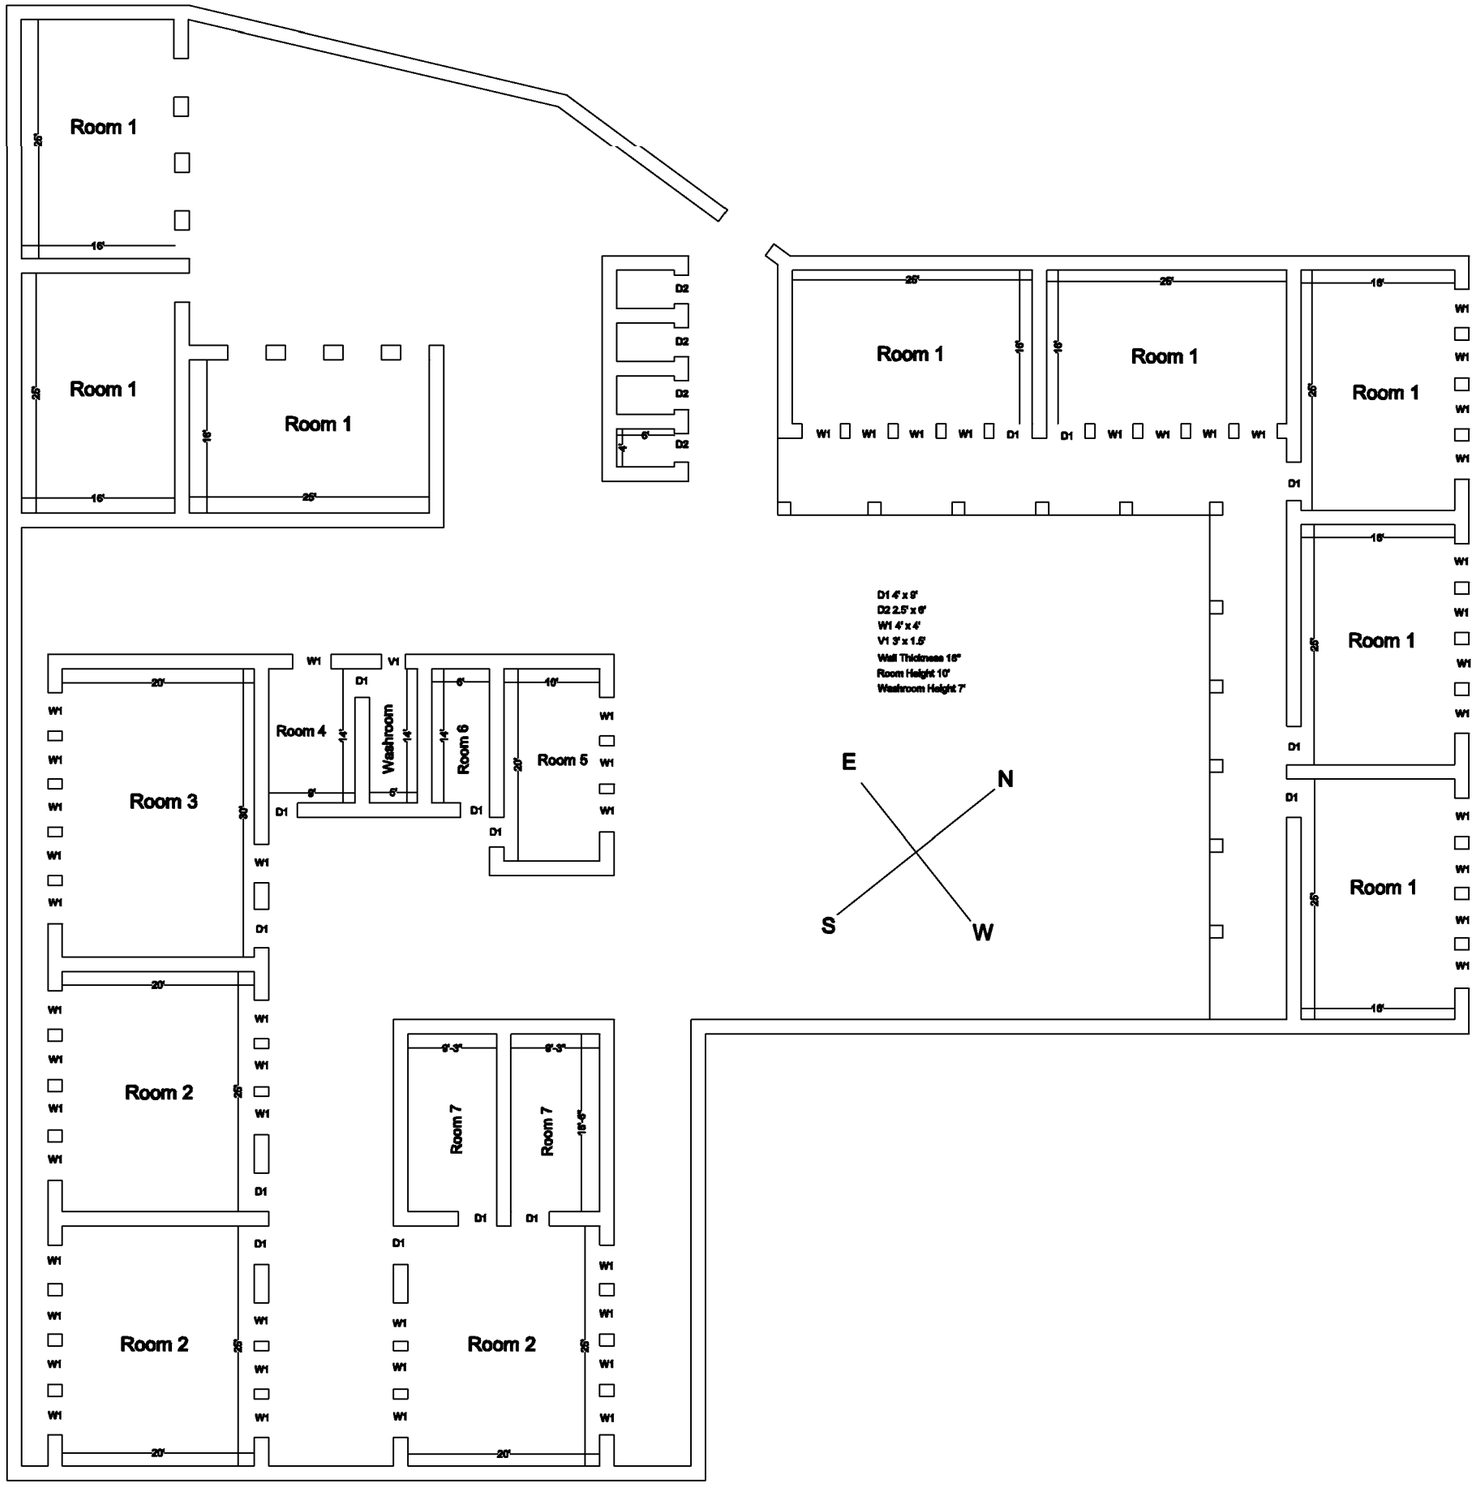

Room 1
Room 1
Room 1
Room 1
Room 1
Room 1
Room 1
Room 1
Room 1
Room 4
Washroom
Room 6
Room 5
Room 3
Room 2
Room 2
Room 7
Room 7
Room 2
D1 4' x 8'
D2 2.5' x 6'
W1 4' x 4'
V1 3' x 1.5'
Wall Thickness 16"
Room Height 10'
Washroom Height 7'
E
N
S
W